

7224-01-A
 Single Storey Brick Building
 Cedar Terrace Sports Pavilion
 67.24
 79.27

East Ayrshire Council
 Safer Communities
 Facilities and Property Management
 Opera House
 8 John Finnie Street
 Kilmarnock

Project/Location 7224 Cedar Terrace Sports Pavilion
 Cedar Terrace
 Dalmellington
 KA6 6DT


Drawing Title **GROUND FLOOR**
 Scale **1:50**
AS BUILT SURVEY
 Date May 2009

Confirmed Asbestos Element Identified
 In this location
 Inaccessible areas identified as
 Presumed Asbestos
 No Asbestos Detected
 All Intrusive works will require further testing
 Re-Inspection Photo



HyperLinks
[VIEW ROOM LIST](#)
[VIEW 3D MODEL](#)
[VIEW OVERVIEW PHOTO](#)
[VIEW SITE PLAN](#)



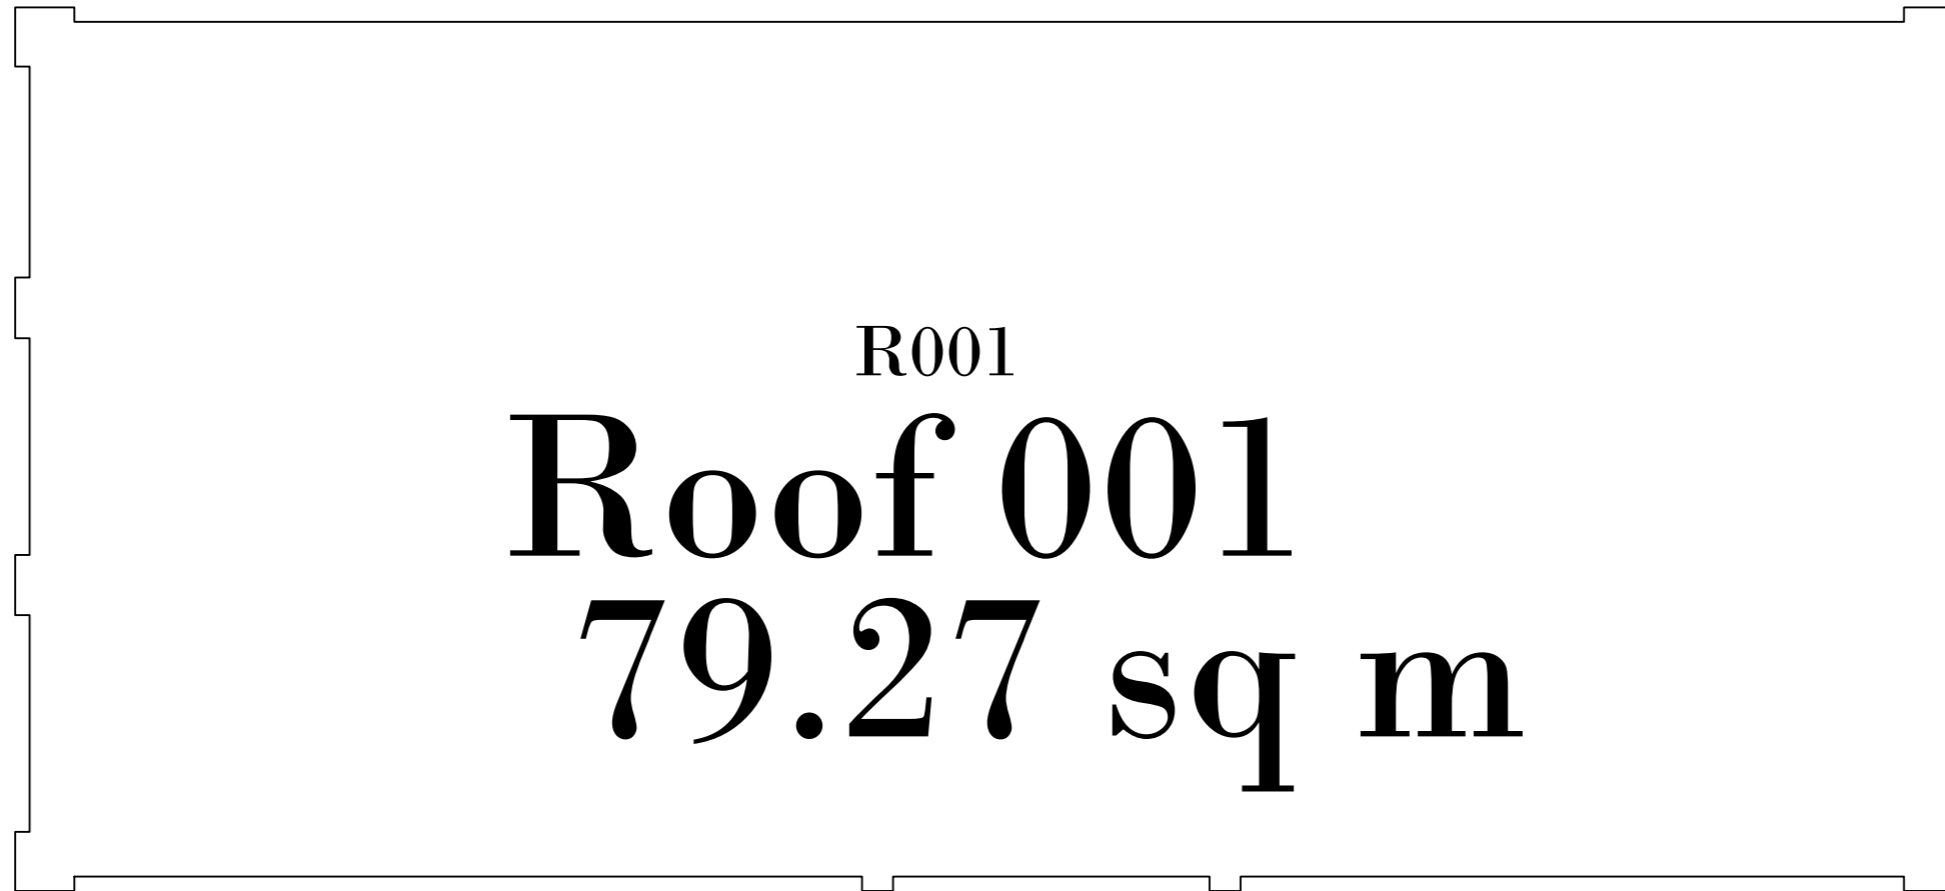

East Ayrshire Council
 Safer Communities
 Facilities and Property Management
 Opera House
 8 John Finnie Street
 Kilmar nock

Project/Location 7224 Cedar Terrace Sports Pavilion
 Cedar Terrace
 Dalmellington
 KA6 6DT

Drawing Title **ROOFING PLAN**
AS BUILT SURVEY

Scale **1:50**

Date May 2009



Tel.01563 50-3456
 stewart.f.inlay@east-ayrshire.gov.uk